


# 18/8130 Rye Croft and Sike House, Stainton



revision:	date:	description:
A	12.10.16	boundary amended; house types amended
B	31.10.16	post and wire fence and styles added to public footpath
C	03.11.16	red/blue line amended
D	03.11.16	red line extended to roadway

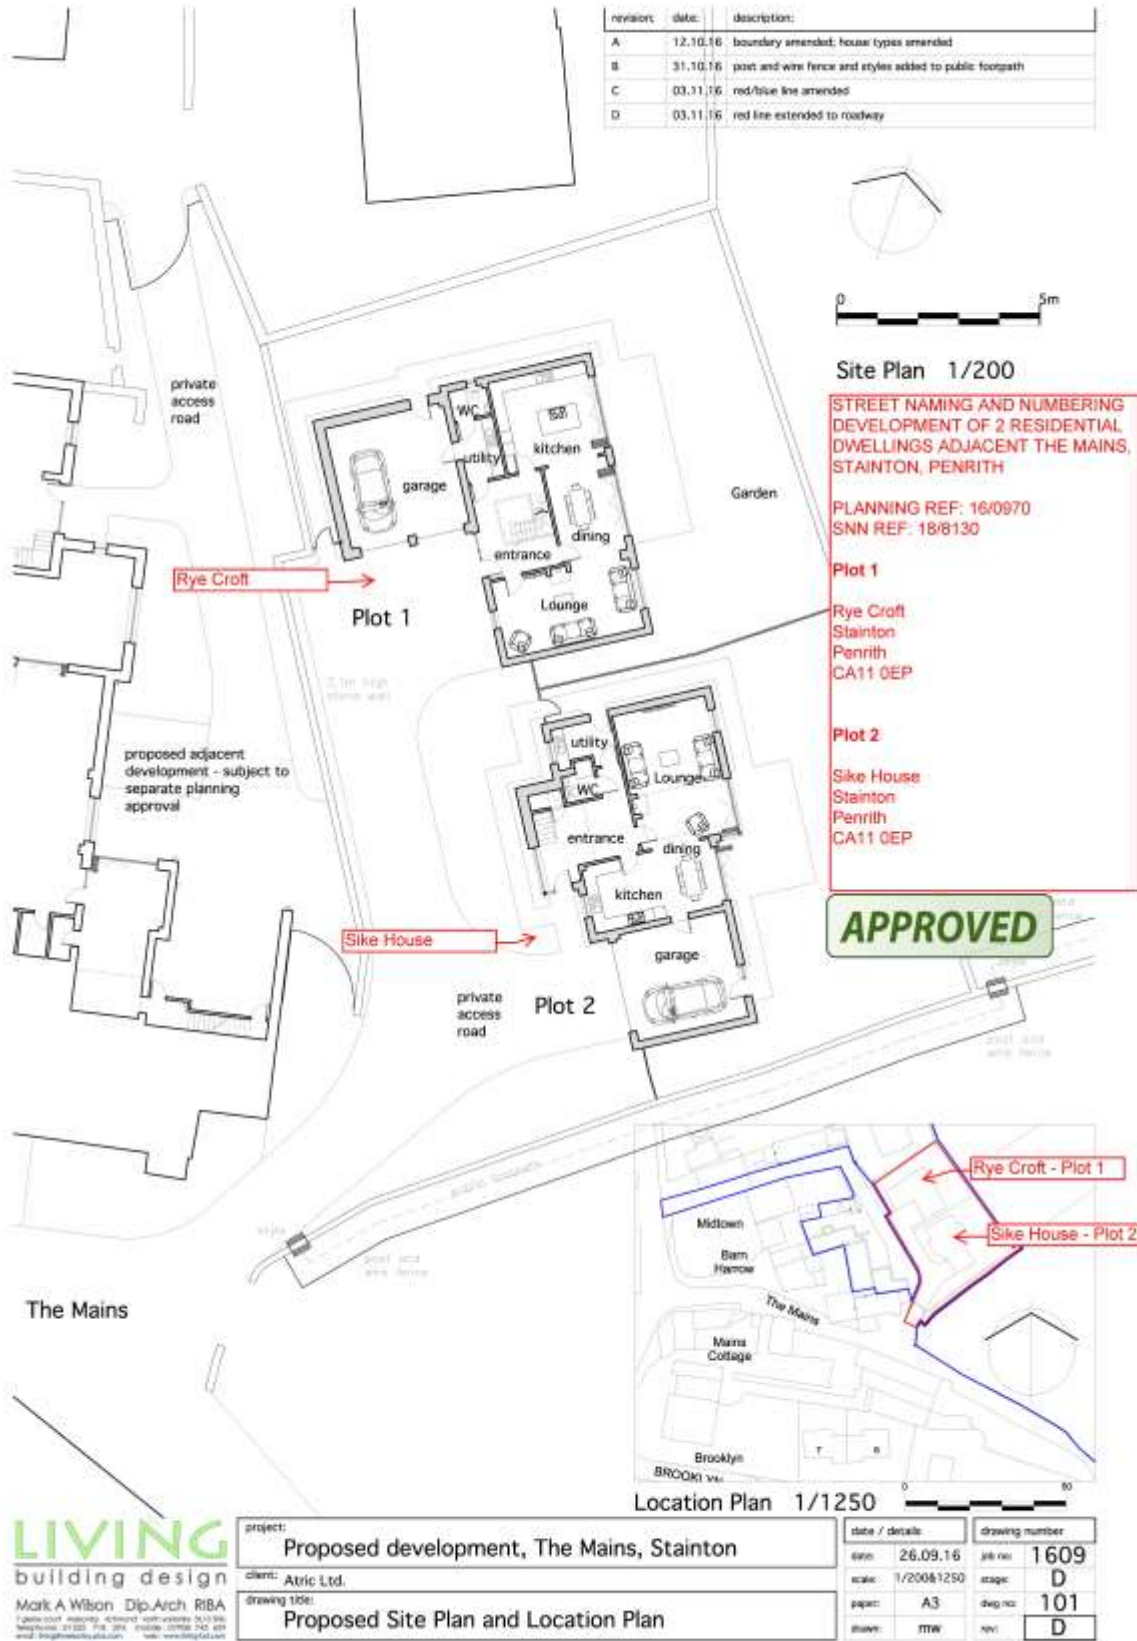

0 5m

Site Plan 1/200

**STREET NAMING AND NUMBERING  
DEVELOPMENT OF 2 RESIDENTIAL  
DWELLINGS ADJACENT THE MAINS,  
STAINTON, PENRITH**

PLANNING REF: 16/0970  
SNN REF: 18/8130

**Plot 1**

Rye Croft  
Stainton  
Penrith  
CA11 0EP

**Plot 2**

Sike House  
Stainton  
Penrith  
CA11 0EP

**APPROVED**



Location Plan 1/1250

0 50

**LIVING**  
building design  
Mark A Wilson Dip.Arch RIBA  
1 Gable Court, Leazes Road, Newcastle, Tyne & Wear  
NE4 6BE  
Tel: 0191 276 2991 Fax: 0191 276 2992  
www.livingbuildingdesign.co.uk

project:	Proposed development, The Mains, Stainton
client:	Abric Ltd.
drawing title:	Proposed Site Plan and Location Plan

date / details	drawing number
date: 26.09.16	job no: 1609
scale: 1/200&1250	stage: D
paper: A3	dwg no: 101
drawn: MWW	rev: D